

Client




Consultant



DESIGNER:



Contractor

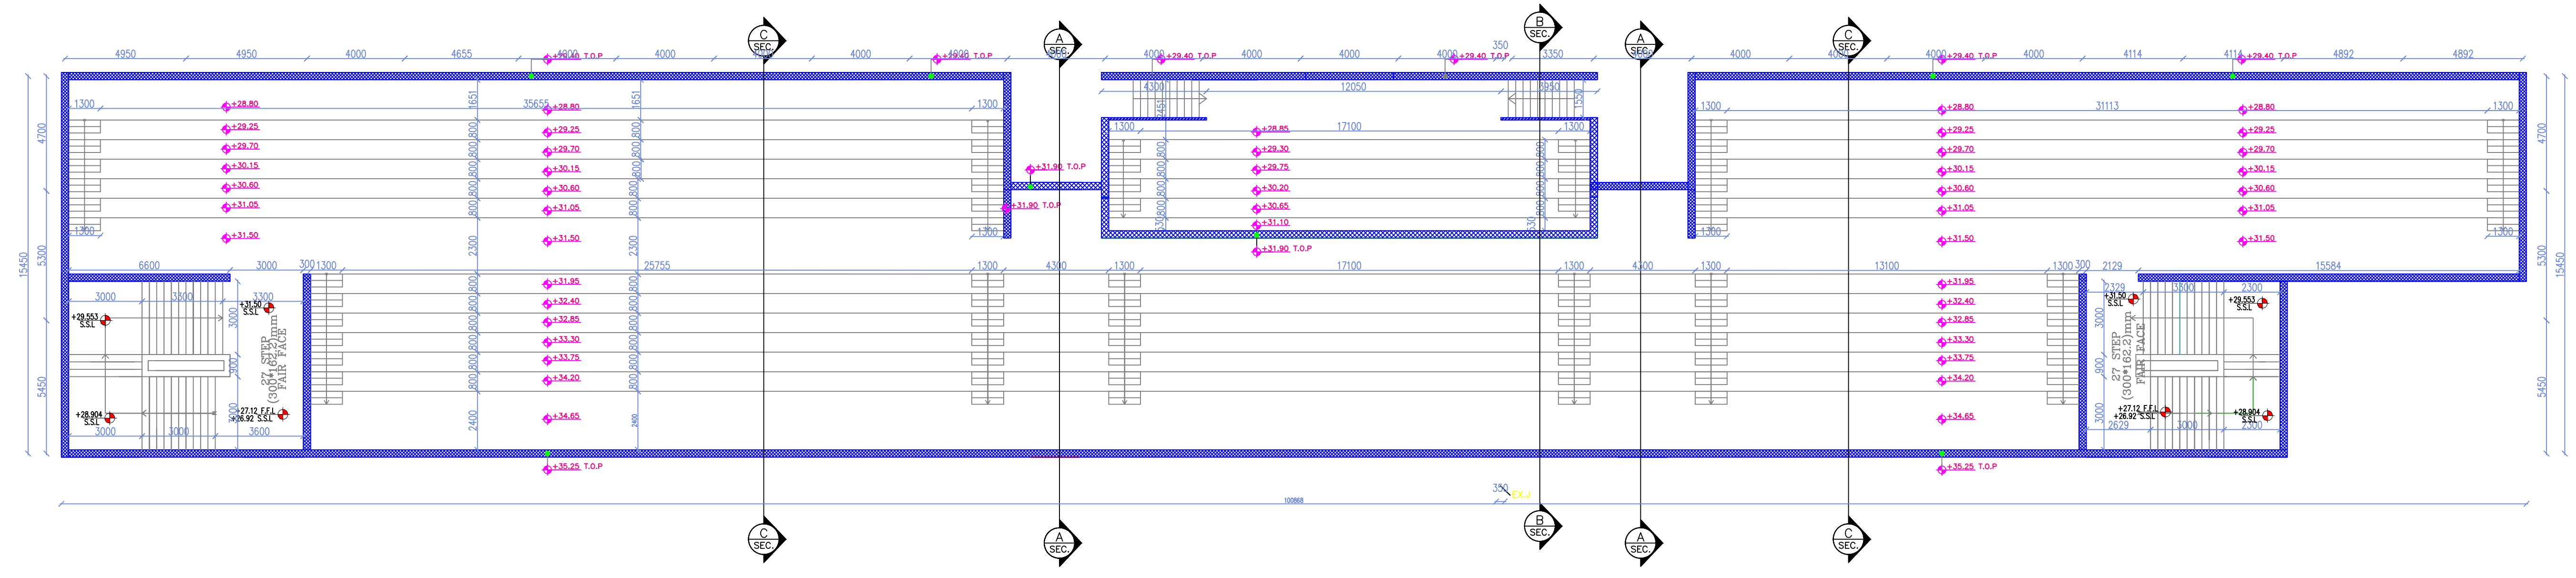

PLAN FOR EAST SERVICE BUILDING
SCALE 1:150

NOTES

No.	DESCRIPTION
1.	- ALL DIMENSIONS ARE IN (mm) UNLESS OTHERWISE INDICATED.
2.	- ALL LEVELS ARE IN METERS UNLESS OTHERWISE INDICATED.

LEGENDS

F.F.L: FINISH FLOOR LEVEL
T.O.P: TOP OF PARAPET
S.S.L: SOLID SLAB OR SLAB ON GRADE LEVEL
SEC.: SECTION

REVISIONS

No.	DESCRIPTION	DATE	APPROVED
1.	REV-00	15/10/2017	
2.			
3.			

ASBUILT

اسم المشروع: مشروع
اعداد الدراسات والتصاميم للمتابعة التدرجية
عطاء رقم: 2/16/1/10
الملاعب التدريبية النموذجية


Drawing Titel:
ARCHITECTURAL PLAN AND SECTION
FOR EAST STADIUM

DESIGNER	NAME
CAD INPUT BY	Eng. (B.R)
CHECKED BY	Eng. (M.Q)
APPROVED BY	Eng. (A.AW)

SITE NO.	Aqaba (Project / 4)
REGION NO.
DATE	28/10/2017
SCALE	1:100

REFERENCE DWG : A204

SHEET No.	DWG No.
A.D.C.C./ABC	ARCH-12 01 OF 01

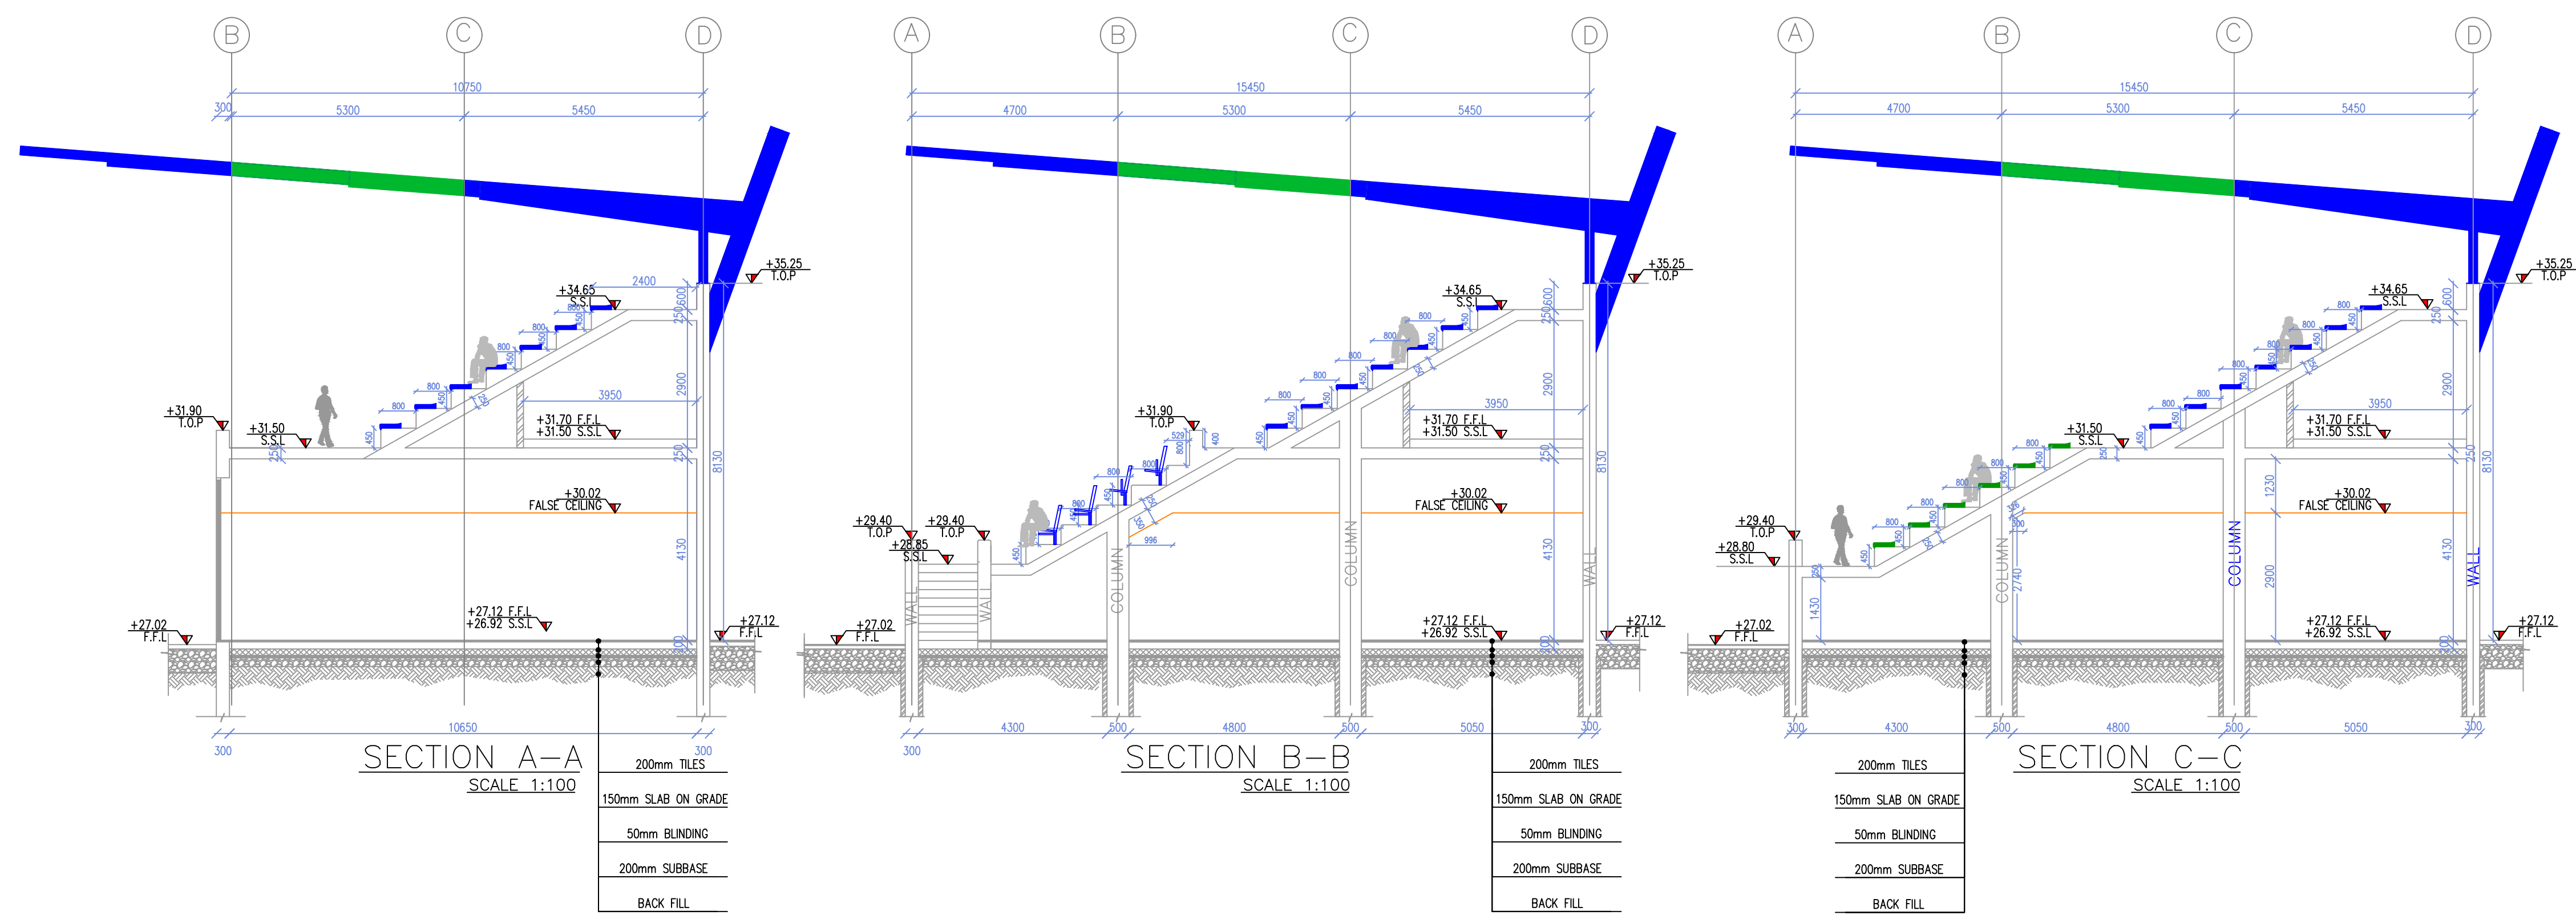

SECTION A-A
SCALE 1:100

SECTION B-B
SCALE 1:100

SECTION C-C
SCALE 1:100

- 200mm TILES
- 150mm SLAB ON GRADE
- 50mm BLINDING
- 200mm SUBBASE
- BACK FILL

- 200mm TILES
- 150mm SLAB ON GRADE
- 50mm BLINDING
- 200mm SUBBASE
- BACK FILL

- 200mm TILES
- 150mm SLAB ON GRADE
- 50mm BLINDING
- 200mm SUBBASE
- BACK FILL