


PLAN FOR WEST SERVICE BUILDING  
SCALE 1:150

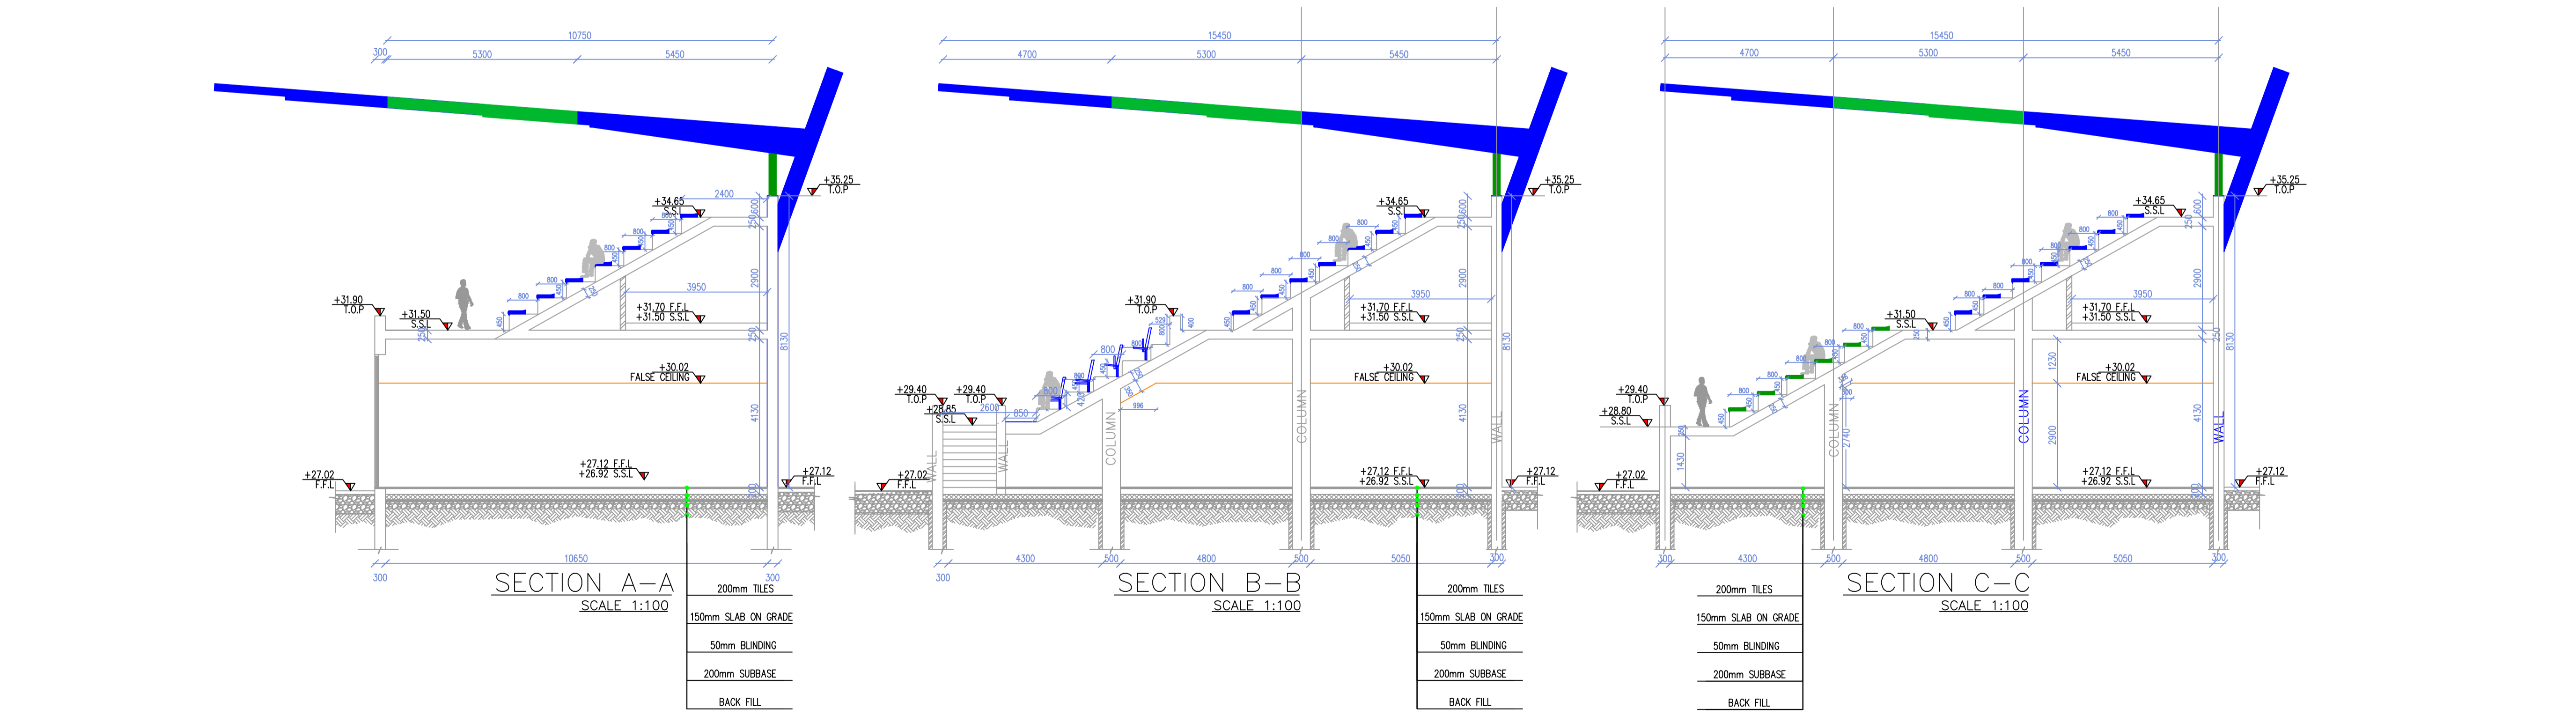

SECTION A-A  
SCALE 1:100

SECTION B-B  
SCALE 1:100

SECTION C-C  
SCALE 1:100



Client



Consultant



DESIGNER:



Contractor



NOTES

| No. | DESCRIPTION  |
|-----|--|
| 1.  | - ALL DIMENSIONS ARE IN (mm) UNLESS OTHERWISE INDICATED. |
| 2.  | - ALL LEVELS ARE IN METERS UNLESS OTHERWISE INDICATED.   |

LEGENDS

F.F.L.: FINISH FLOOR LEVEL  
T.O.P.: TOP OF PARAPET  
S.S.L.: SOLID SLAB OR SLAB ON GRADE LEVEL  
SEC.: SECTION

REVISIONS

| No. | DESCRIPTION | DATE       | APPROVED |
|-----|-------------|------------|----------|
| 1.  | REV.00      | 15/10/2017 |          |
| 2.  |             |            |          |
| 3.  |             |            |          |

ASBUILT

اسم المشروع: مشروع  
اعداد الدراسات والتصاميم لانشاء الملاعب التدريبية  
خطه رقم: 10 / 10 / 10  
الملاعب التدريبية النموذجية

Drawing Titel:

ARCHITECTURAL PLAN AND SECTION FOR WEST STADIUM

| DESIGNER     | NAME        |
|--------------|-------------|
| CAD INPUT BY | Eng. (B.R)  |
| CHECKED BY   | Eng. (M.Q)  |
| APPROVED BY  | Eng. (A.AW) |

|            |                     |
|------------|---------------------|
| SITE NO.   | Aqaba (Project / 4) |
| REGION NO. | .....               |
| DATE       | 28/10/2017          |
| SCALE      | 1:100               |

REFERENCE DWG : A204

|              |                     |
|--------------|---------------------|
| SHEET No.    | DWG No.             |
| A.D.C.C./ABC | ARCH-06<br>01 OF 01 |